


LINESET SCHEDULE								
LINESET	CL. OF BATTEN FROM FL	CL. OF HEADBLOCK FROM FL	DESCRIPTION	BATTEN TYPE	BATTEN LENGTH	ARBOR LENGTH	VERTICAL TRAVEL LIMIT (PLF)	WORKING LOAD LIMIT (PLF)
1	0'-10 1/2"	1'-4"	PORTAL HEADER	1.5" SCH. 40 BATTEN	60'-0"	DP 11'-0"	42'-0"	25 PLF
(PL)	1'-7"	N/A	PORTAL LEGS	1.5" SCH. 80 BATTEN W/ 283 TRACK	68'-7"	DEAD HUNG	NA	30 PLF
(HC)	2'-5"	N/A	MAIN CURTAIN	1.5" SCH. 80 BATTEN W/ 283 TRACK	68'-7"	DEAD HUNG	NA	30 PLF
4	3'-4"	3'-4"	#1 ELECTRIC	1.5" SCH. 40 DOUBLE BATTEN	52'-0"	DP 12'-0"	40'-0"	25 PLF
7	5'-4"	5'-4"	NEW SET	1.5" SCH. 40 BATTEN	52'-0"	DP 11'-0"	42'-0"	25 PLF
10	7'-4"	7'-4"	#1 ACOUSTIC SHELL	1.5" SCH. 80 BATTEN	52'-0"	DP 12'-0"	40'-0"	27 PLF
13	9'-4"	9'-4"	#1 BORDER	1.5" SCH. 40 BATTEN	52'-0"	DP 11'-0"	42'-0"	25 PLF
14	10'-0"	10'-0"	MIDSTAGE TRAVELLER	1.5" SCH. 40 BATTEN W/ 283 TRACK	52'-0"	DP 11'-0"	42'-0"	25 PLF
16	11'-4"	11'-4"	#2 ELECTRIC	1.5" SCH. 40 DOUBLE BATTEN	52'-0"	DP 11'-0"	40'-0"	25 PLF
17	12'-0"	12'-0"	NEW SET	1.5" SCH. 40 BATTEN	52'-0"	DP 11'-0"	42'-0"	25 PLF
18	12'-8"	12'-8"	PROJECTION SCREEN	1.5" SCH. 40 BATTEN	52'-0"	DP 11'-0"	42'-0"	25 PLF
21	14'-8"	14'-8"	NEW SET	1.5" SCH. 40 BATTEN	52'-0"	DP 11'-0"	42'-0"	25 PLF
22	15'-4"	15'-4"	#2 ACOUSTIC SHELL	1.5" SCH. 80 BATTEN	52'-0"	DP 12'-0"	40'-0"	27 PLF
23	16'-2"	16'-0"	NEW SET	1.5" SCH. 40 BATTEN	52'-0"	DP 11'-0"	42'-0"	25 PLF
24	16'-8"	16'-8"	#2 BORDER	1.5" SCH. 40 BATTEN	52'-0"	DP 11'-0"	42'-0"	25 PLF
25	17'-4"	17'-4"	#1 LEG	1.5" SCH. 40 BATTEN	52'-0"	DP 11'-0"	42'-0"	25 PLF
26	18'-0"	18'-0"	NEW SET	1.5" SCH. 40 BATTEN	52'-0"	DP 11'-0"	42'-0"	25 PLF
28	19'-4"	19'-4"	#3 ELECTRIC	1.5" SCH. 40 DOUBLE BATTEN	52'-0"	DP 11'-0"	40'-0"	25 PLF
31	21'-4"	21'-4"	NEW SET	1.5" SCH. 40 BATTEN	52'-0"	DP 11'-0"	42'-0"	25 PLF
32	22'-0"	22'-0"	NEW SET	1.5" SCH. 40 BATTEN	52'-0"	DP 11'-0"	42'-0"	25 PLF
33	22'-8"	22'-8"	NEW SET	1.5" SCH. 40 BATTEN	52'-0"	DP 11'-0"	42'-0"	25 PLF
34	23'-4"	23'-4"	#3 ACOUSTIC SHELL	1.5" SCH. 80 BATTEN	52'-0"	DP 12'-0"	40'-0"	27 PLF
35	24'-2"	24'-0"	NEW SET	1.5" SCH. 40 BATTEN	52'-0"	DP 11'-0"	42'-0"	25 PLF
36	24'-8"	24'-8"	#3 BORDER	1.5" SCH. 40 BATTEN	52'-0"	DP 11'-0"	42'-0"	25 PLF
37	25'-4"	25'-4"	#2 LEG	1.5" SCH. 40 BATTEN	52'-0"	DP 11'-0"	42'-0"	25 PLF
38	26'-0"	26'-0"	SCRIM	1.5" SCH. 40 BATTEN	52'-0"	DP 11'-0"	42'-0"	25 PLF
39	26'-8"	26'-8"	UPSTAGE TRAVELLER	1.5" SCH. 40 BATTEN W/ 283 TRACK	52'-0"	DP 11'-0"	42'-0"	25 PLF
40	27'-4"	27'-4"	#4 ELECTRIC	1.5" SCH. 40 DOUBLE BATTEN	51'-0"	DP 11'-0"	40'-0"	25 PLF
42	28'-8"	28'-8"	CYC	1.5" SCH. 40 BATTEN	52'-0"	DP 11'-0"	42'-0"	25 PLF
AW	29'-2"	NA	ACOUSTIC WALL	2" SCH. 80 BATTEN W/888 TRACK	55'-0"	DEAD HUNG	NA	30 PLF

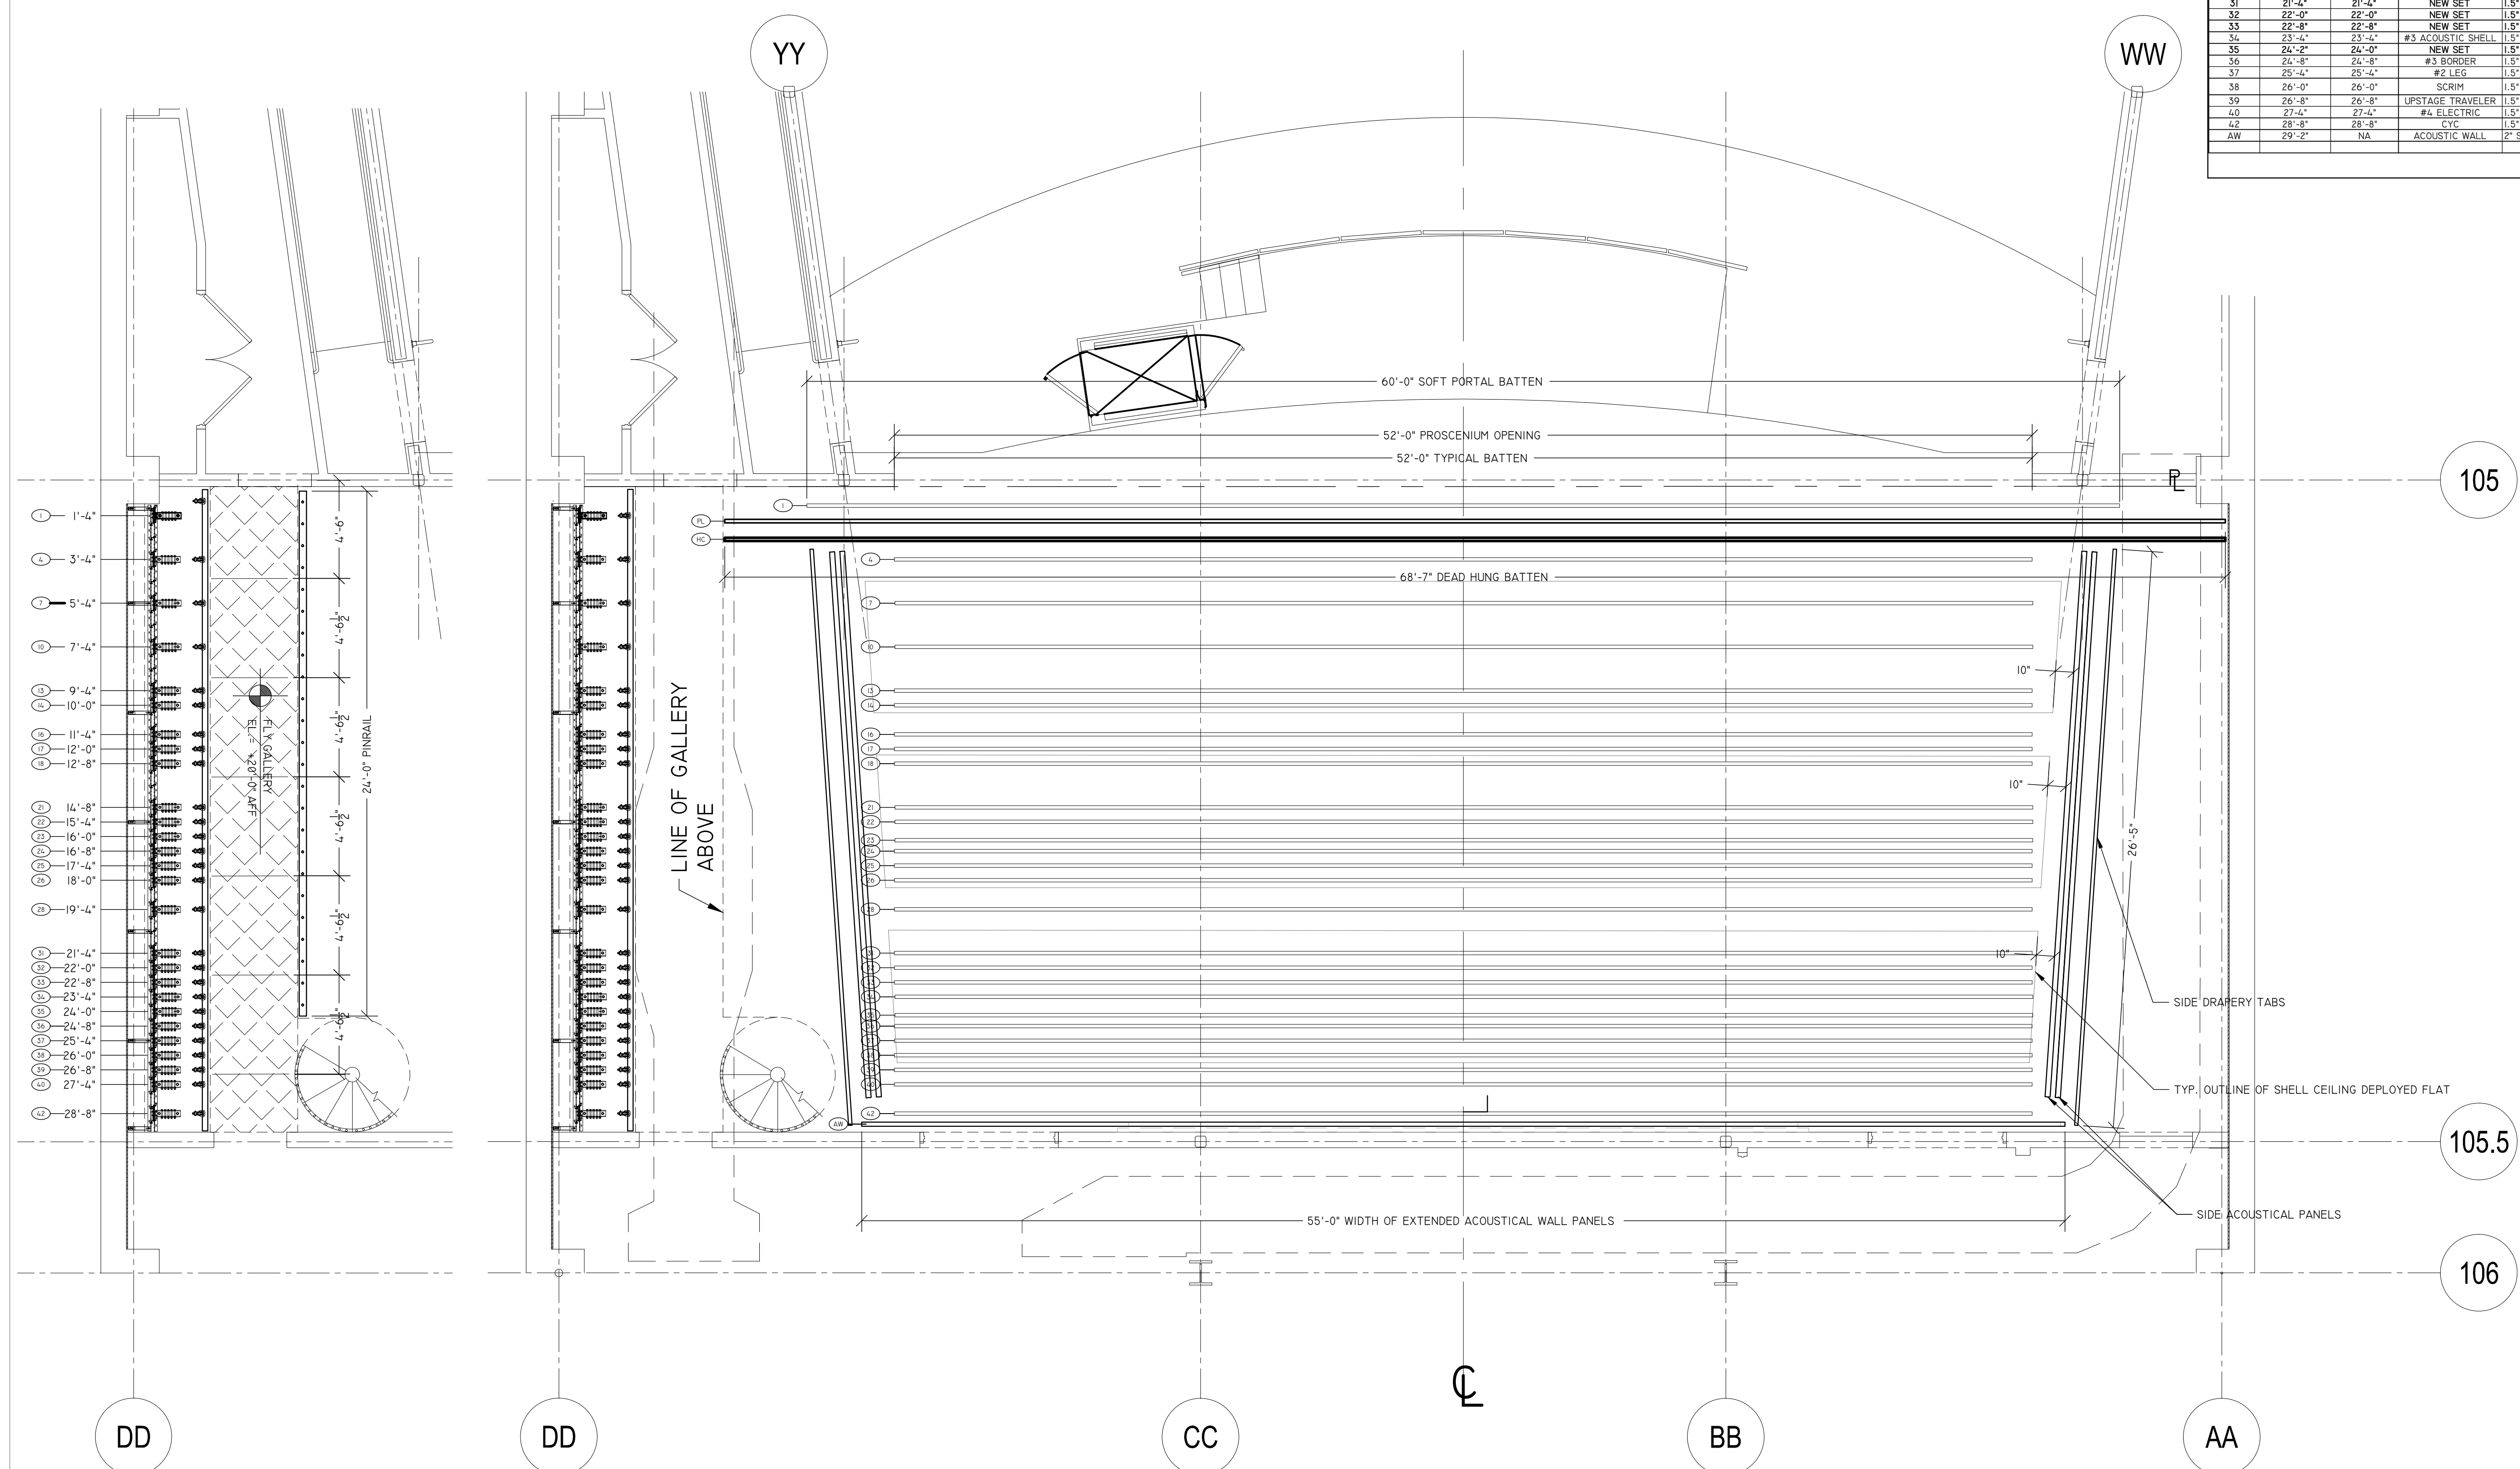


2 PLAN AT FLY GALLERY SCALE: 1/4" = 1'-0"

1 BATTEN PLAN SCALE: 1/4" = 1'-0"

REV.	DATE	DESCRIPTION
4	1-10-12	AS BUILT- JAN 2012 MOLLOY ADDITIONS
3	1-10-12	AS BUILT- DGD CONTRACT
2	7-26-11	RELEASE TO FIELD-PHASE 2
1	3-22-11	RELEASE TO FIELD
1	3-14-11	REVISION-PER AAN SUBMITTAL COMMENTS
	2-2-11	SUBMITTAL

PROJECT: MOLLOY COLLEGE CAMPUS CENTER ROCKVILLE CENTER, NY		POOK DIEMONT & OHL, INC. 701 EAST 152ND STREET BRONX, NEW YORK 10454 718-402-2677 718-402-2859 FAX	
DWG. TITLE: BATTEN PLAN		ARCHITECT: BUTLER ROGERS BASKETT	
MANUFACTURER:		CONSULTANT: CHARLES COSLER THEATER DESIGN	
SCALE: AS NOTED		GENERAL CONTRACTOR: DAMON G. DOUGLAS COMPANY	
DRAWN BY: KDC	DATE: 1/21/11	JOB NUMBER: 29-0614	DRAWING NUMBER:

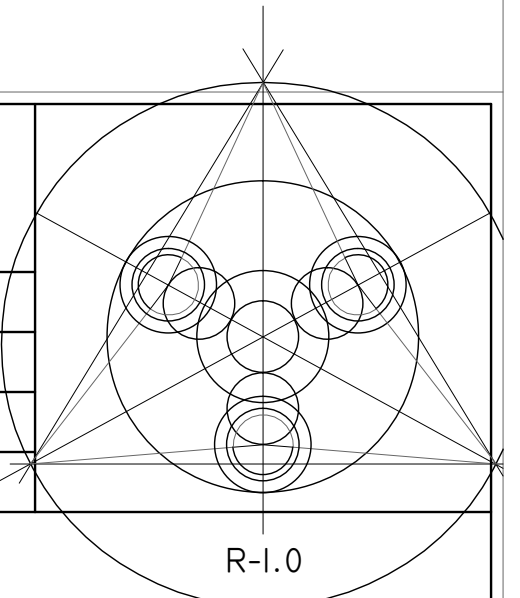

R-1.0